


APPENDIX B

Ground floor plan:

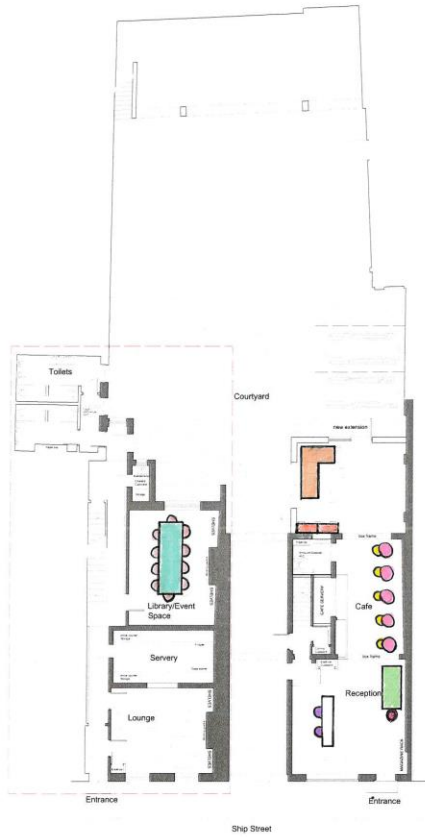

01 Ground Floor Plan
1:20 Scale 1/10


= x1 Studio cafe table (100 diameter)

- = Large collaboration table 3600 x 1180 mm (x1)
- = Nora meeting chair - ply with white (x10)
- = Vento 3 seater (right hand) (2610 x 930 / 1680)
- = x2 Maine storage locker (1000 x 457)
- = x5 Hugo pedestal table (600 diameter)
- = x5 Hipster milner chairs
- = Scott sofa (2250 x 1000)
- = x2 Kabi swivel chairs

ISSUED FOR AS BUILT

YELLO	
Yello Architects Ltd Over House, 18 Marina Parade, Brighton, BN2 1TL	
T: 01273 502 444 E: hello@yello.co.uk W: www.yello.co.uk	
PROJECT	YO248 8-9 Ship Street Brighton
DRAWING TITLE	Ground Floor Plan
DRAWING NO	YO248-120
SCALE	1/100 @ A1
DATE	May 2018
REV	AB

First floor plan:

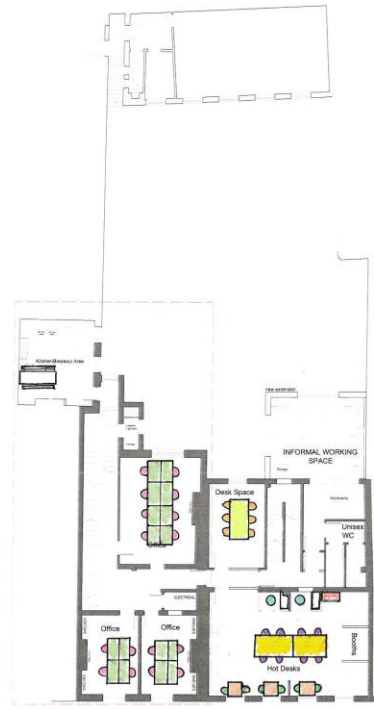

01 First Floor Plan
1/1 Scale 1:500

- = Victoria metal stool
- = x1 Bridge table (2200 x 1100)
- = x6 Kabi four legs with arms
- = x1 Maine storage locker (1000 x 457)

- = x2 Forty A0 tables (2000 x 1200)
- = x8 Kabi swivel chairs
- = x3 Angle tables (800 x 800)
- = x6 Trapeze chairs
- = x16 Theo desk (1200 x 650) ^{or}
- = x16 Soft pad office chair ^{or} Trapeze desk


ISSUED FOR AS BUILT

YELU Yelo Architects Ltd
 18 Marine Parade,
 Brighton
 BN2 1TL

PROJECT: Y0246
 8-9 Ship Street,
 Brighton

DRAWING TITLE: First Floor Plan
 DRAWING NO: Y0246 - 121
 SCALE: 1:100 @ A1
 DATE: May 2018
 REV: AB

Second floor plan:

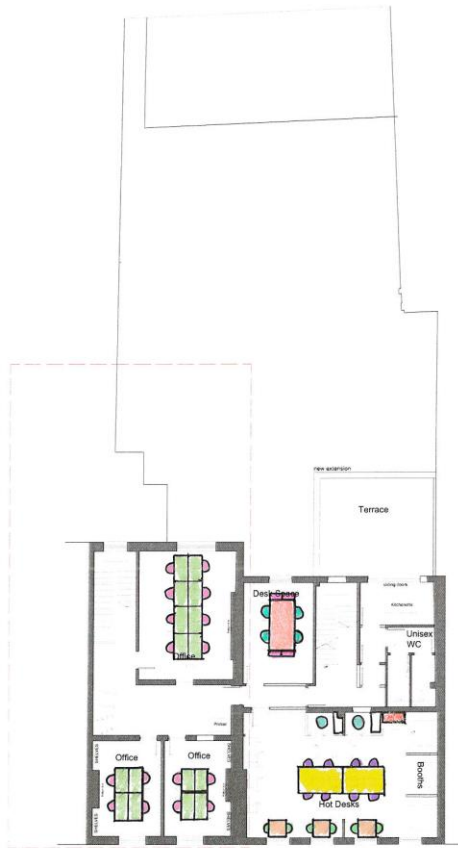

01 Second Floor Plan
Scale: 1:100

[Red rectangle] = x1 Main storage locker (1000 x 457)

[Teal rectangle] = Victoria metal stool

[Yellow rectangle] = x2 Forty 40 tables (2000 x 1200)

[Purple rectangle] = x8 Kabi swivel chairs

[Orange rectangle] = x3 Angle tables (800 x 800)

[Light green rectangle] = x6 Trapeze chairs

[Green rectangle] = x16 Theo desk (1200 x 650) *

[Pink rectangle] = x16 Soft pad office chair

[Light orange rectangle] = x1 lean desk (2400 x 1300)

[Teal rectangle] = x4 Low back office chairs

[Pink rectangle] = x4 pedestal storage (522 x 325)

ISSUED FOR AS BUILT

Yelo
Yelo Architects Ltd
Oliver House,
15 Marine Parade,
Brighton
BN2 1TL
Tel: 01273 558 111
Fax: 01273 558 111
Email: info@yeloarchitects.com
www.yeloarchitects.com
Twitter: @yeloarchitects

PROJECT	Y0246 8-9 Ship Street Brighton
DRAWING TITLE	Second Floor
DRAWING NO	Y0246 - 122
SCALE	1/100 @ A1
DATE	May 2016
REV	AB

* or Trapeze desk

